

020016152

NORTHEAST TRI COUNTY HEALTH DISTRICT  
DIVISION OF ENVIRONMENTAL HEALTH  
ON-SITE SEWAGE SYSTEM PERMIT # 1000268

Martin & Kathleen Alvstad is hereby authorized to utilize a sewage disposal system at

SUBDIVISION First Thought River Tracts LOT 12  
Section: 14 Township: 40 Range: 36 Parcel # 6-40-14-50-00120-00

in accordance with the plans and specifications approved by the District Health Officer on file in this office.

Prior to any major repairs, replacements or alterations to the system a permit shall be obtained from the Northeast Tri County Health District (Division of Environmental Health).

This permit is issued and may be revoked by the Northeast Tri County Health District Health Officer by authority of WAC 246-272, and Northeast Tri County Health District Regulations established by the Board of Health pursuant to RCW 70.05.

Additional permits from other jurisdictions or agencies may be necessary for this project. It is the responsibility of the applicant to acquire said permit (s), and comply with all applicable rules, regulations and/or ordinances.

District Health Officer

Date Issued: 09/10/2001

2510  
17-40-34

PERMIT INSTRUCTIONS

STRUCTURE TYPE: Single Family Residence  
NUMBER OF BEDROOMS: 3  
DESIGN FLOW (gal/day): 240-360  
TYPE OF SYSTEM: New  
SYSTEM DESIGN: Conventional Gravity  
SEPTIC TANK CAPACITY (gal): 1000

DFLF/BED DIMENSIONS: 150  
TRENCH DEPTH (inches): 36  
TRENCH WIDTH (inches): 36  
APPURTANENCES: D- Box  
PUMP CHAMBER (y/n): N  
PUMP CHAMBER GALLONS: 0

REASON SYSTEM DESIGN:

SPECIAL PERMIT INSTRUCTIONS:

FINAL INSPECTION DATE: 9, 17, 01


INITIALS: NMA

\*\* SEE REVERSE FOR AS BUILT DRAWING

- |                              |              |                    |                |
|------------------------------|--------------|--------------------|----------------|
| * Stevens County Office      | P.O. Box 270 | Colville, WA 99114 | (509) 684-2262 |
| * Pend Oreille County Office | P.O. Box 490 | Newport, WA 99156  | (509) 447-3131 |
| * Ferry County Office        | P.O. Box 584 | Republic, WA 99166 | (509) 775-3111 |

FINAL AS-BUILT DRAWING - PERMIT # 1000268

DATE OF FINAL INSPECTION 9/17/01 BY MA

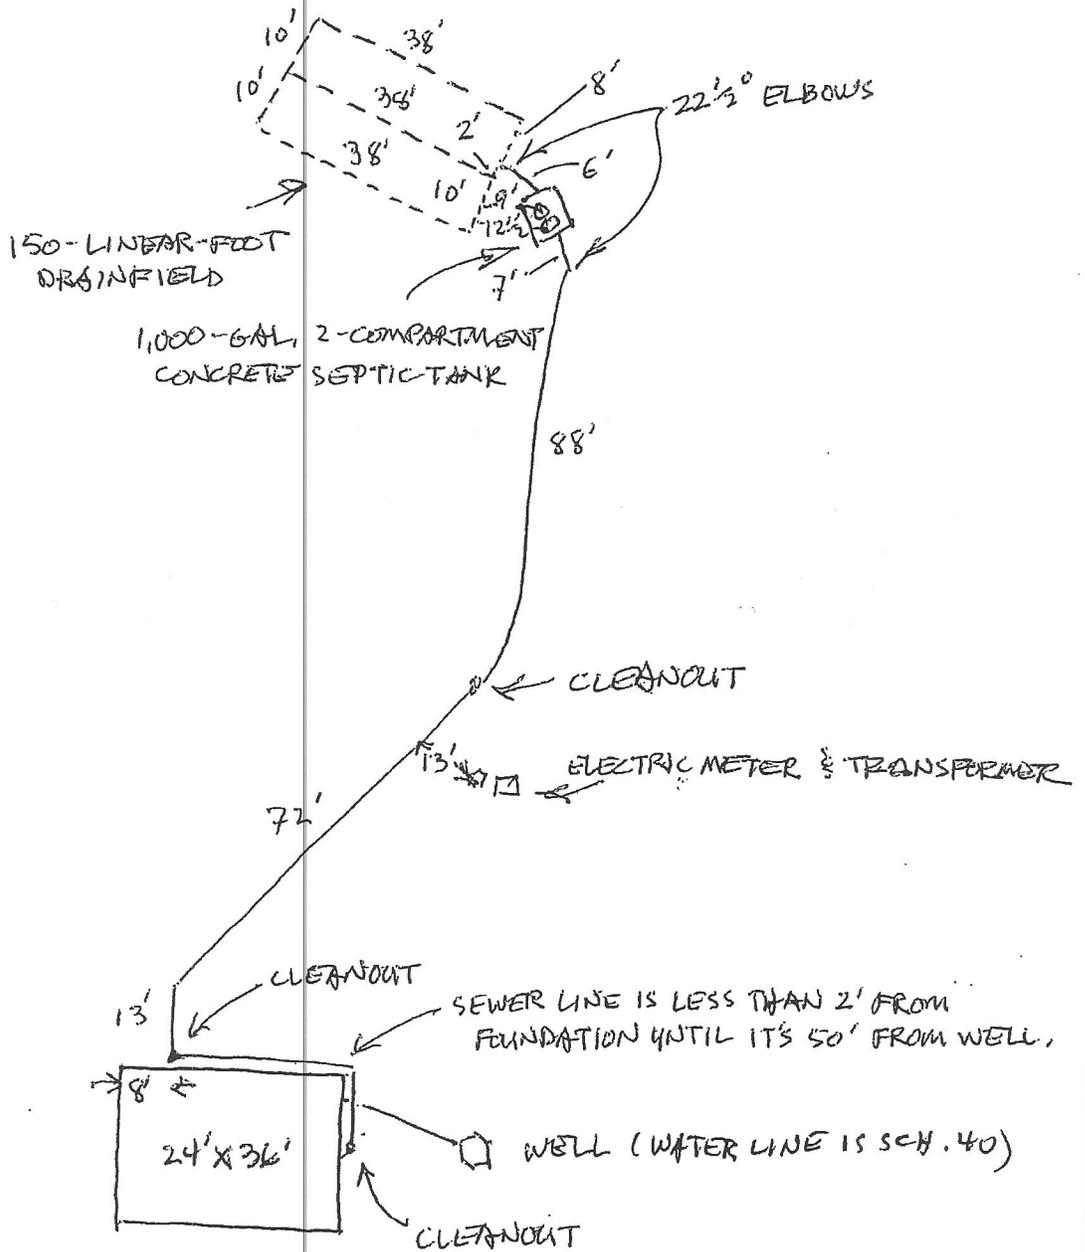

DESIGNED BY OWNER MARTIN ALUSTAD.

INSTALLED BY TIM LINDSEY.

(REVISED 2/98)