

**FAXED**  
6-10-14

Northeast Trl County Health District  
Sewage Permit Record Search Request

The Health District maintains files of permits for completed on-site sewage systems. The sewage permit records contain information such as permit number, date of installation, as-built drawing, septic tank sizing, drainfield location and dimensions, etc. Information from the sewage permit record is useful for locating the septic tank for pumping, when determining locations for outbuildings and driveways, or when property ownership changes.

To obtain sewage permit information, complete this form. It is important to provide as much of this information as possible to ensure the proper sewage permit record matching the legal description provided is located. If a sewage permit is found, a copy of the sewage permit and as-built drawing of the sewage system will be provided.

Request made by (Name) Tammy Ringer Date 6-10-14  
 Address 990190 S. Main City/State Colville Zip 99114  
 Phone # 1084-1012 Fax # 1084-1238

The information in this box must be complete or a copy of the assessor record or a tax statement must be provided.

Name of Current Property Owner Collins, Ron + Jenna  
 Legal Description of Property (rural description or subdivision, lot & block number)  
N+W of line tax #7  
 Section 02 Township 34 Range 39 Parcel # 2173995

Provide as much of the following information as possible. This information is needed to locate sewage permit records if property ownership has changed or the property has been segregated or subdivided.

Ownership History (provide names of previous property owners): Tom Wallace

Sewage Permit # \_\_\_\_\_ Date Sewage System Installed \_\_\_\_\_  
 Type of Structure (residential, commercial, etc.) Residential Age of Structure 1995  
 Has property been segregated or subdivided since the sewage system was installed?  yes  no  
 If yes, date of segregation or subdivision \_\_\_\_\_, plat name or # \_\_\_\_\_

Submit completed form to the Environmental Health office in the county where the property is located

Colville Environmental Health  
 P.O. Box 270  
 Colville, WA 99114  
 1-509-684-2262  
 FAX: 1-509-684-8506

Newport Environmental Health  
 P.O. Box 490  
 Newport, WA 99156  
 1-509-447-9131  
 FAX: 1-509-447-5644

Republic Environmental Health  
 P.O. Box 584  
 Republic, WA 99166  
 1-509-775-3111  
 FAX: 1-509-775-2858

\*\*\* For Office Use Only \*\*\*

Based on the information provided above:

Sewage permit # C7890 was located in the Health District records. The sewage system is sized to serve a 3 bedroom residence

No record of a sewage permit for the legal description provided above was found in the Health District records.

Other \_\_\_\_\_

BY Am Date 6/11/14

JK 4/31

Septic Tank	1000	Gals.
Disp. Field	200	L.F.T.
Other		
(X) New		
( ) Repair		

**NORTHEAST TRI-COUNTY HEALTH DISTRICT**  
 Division of Environmental Health

- ( ) Colville Office, Box 270, Phone 684-2262
- ( ) Newport Office, Box 490, Phone 447-3131
- ( ) Republic Office, Box 584, Phone 775-3161

Permit No. c 7890

Fee Paid \$150.00

Receipt No. 942792

Tom & Kat Wallace is hereby authorized to utilize a sewage disposal

*NW 1/4  
Twp 34*

portion of parcel lying N and W of line described as W line of Sec. 2, Twp. 34, Rge. 39, S49E, 660' N of SW 1/4, a 1153.62' to a point, N to point of and in accordance with the plans and specifications approved by the District Health Officer on file in this office.

Any major repairs or alterations to the system shall be reported to the Northeast Tri-County Health District (Division of Environmental Health) for approval PRIOR to construction.



This permit is issued and may be revoked by the Northeast Tri-County Health District Health Officer by the authority of WAC 246-220 and Rules and Regulations established by the Board pursuant to RCW 70.01.

Witness my hand and seal this 2nd day of July 19 93


Date of inspection 7/16/93 M. J. Muddleston  
 District Health Officer

c 7890  
2-34-39

SR4431

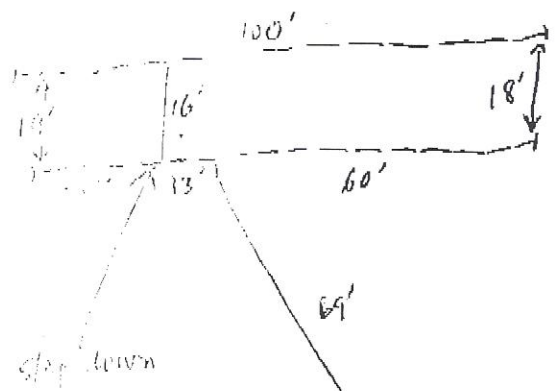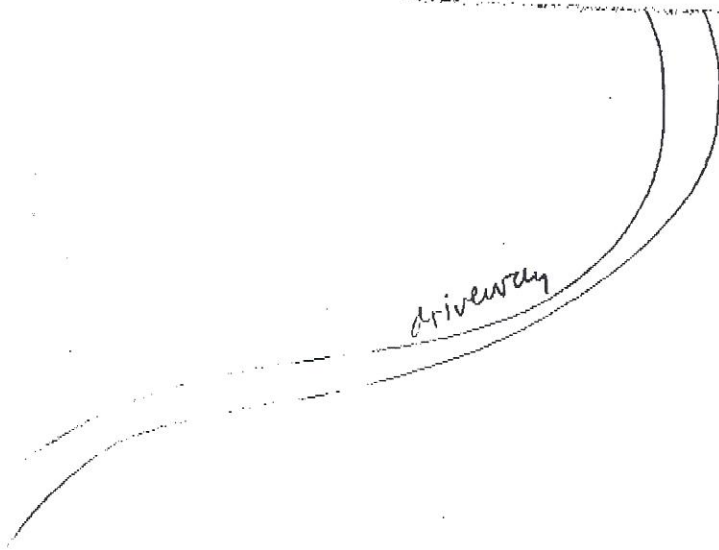

As Built 7/16/93 MAA

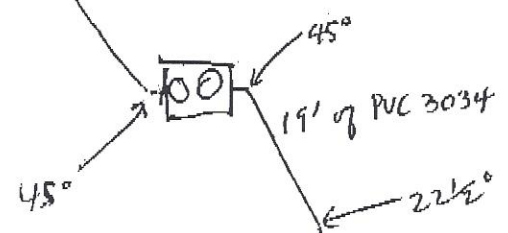

59' up to travel trailer

