

5F 2407

Septic Tank <u>1000</u> _____ Gals.
Disp. Field <u>200'</u> _____ L.F.T
Other _____
<input checked="" type="checkbox"/> New _____
<input type="checkbox"/> Repair _____

NORTHEAST TRI-COUNTY HEALTH DISTRICT
Division of Environmental Health
 Colville Office, Box 270, Phone 684-2262
 Newport Office, Box 490, Phone 447-3131
 Republic Office, Box 584, Phone 775-3161

✓
 C9194
 14-32-38

Permit No. c9194

Fee Paid \$150.00

Receipt No. 643875

Edgar Stovall Jr & Hannelore Stovall is hereby authorized to utilize a sewage disposal system at S of Cr E 1000' E2 SW4 Sec 14 Twp 32 Rng 38 and in accordance with the plans and specifications approved by the District Health Officer on file in this office.

Any major repairs or alterations to the system shall be reported to the Northeast Tri-County Health District (Division of Environmental Health) for approval PRIOR to construction.

This permit is issued and may be revoked by the Northeast Tri-County Health District Health Officer by the authority of WAC 246-272, and Rules and Regulations established by the Board pursuant to RCW 70.05.



Witness my hand and seal this 6th day of October, 19 94

Date of Inspection 11/30/95 Eric Moore
 D.P. Form No. 6134-B



[Signature]
 District Health Officer

SR 2484

AS Built EM / PDG
11/10/99

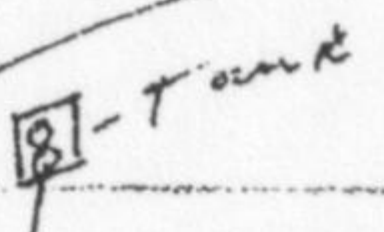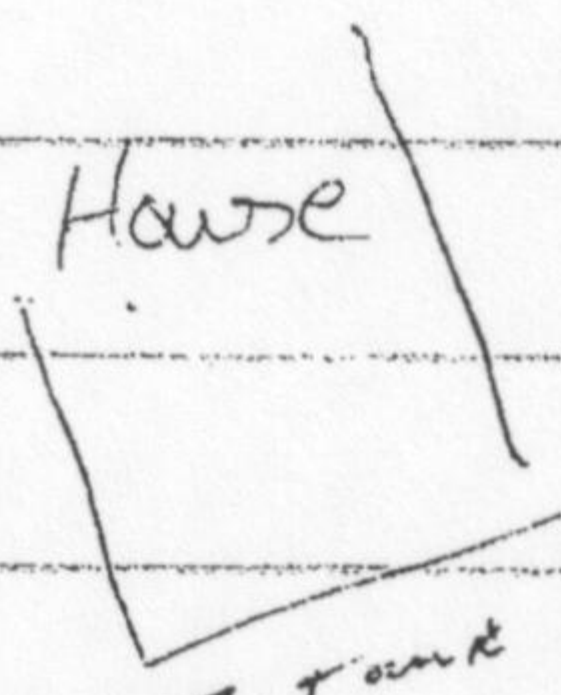



200'

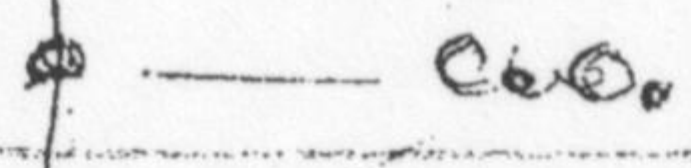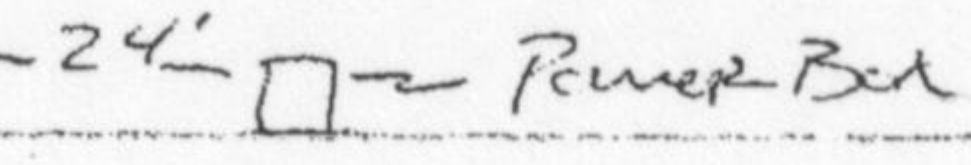

200'

200'

200'

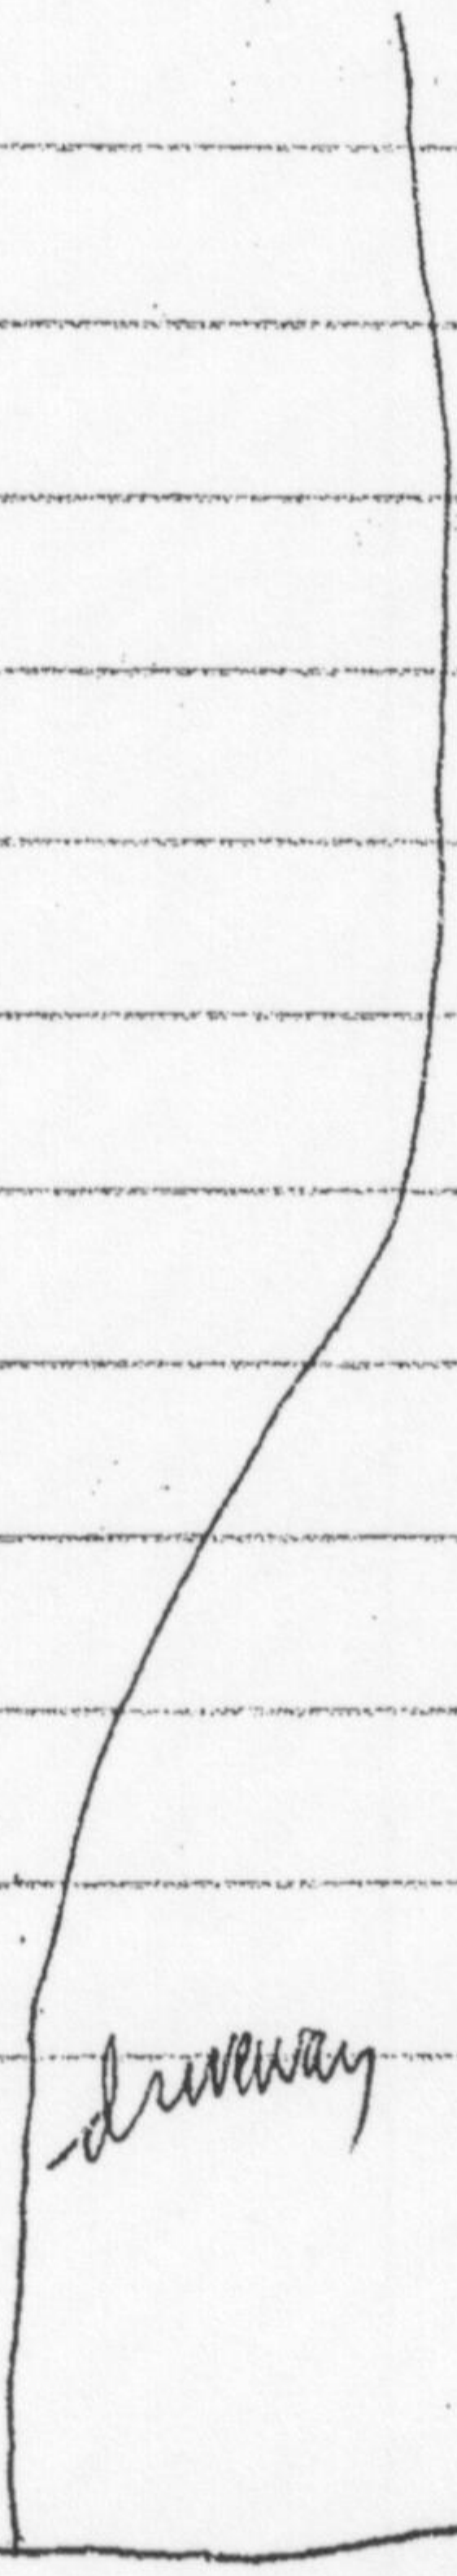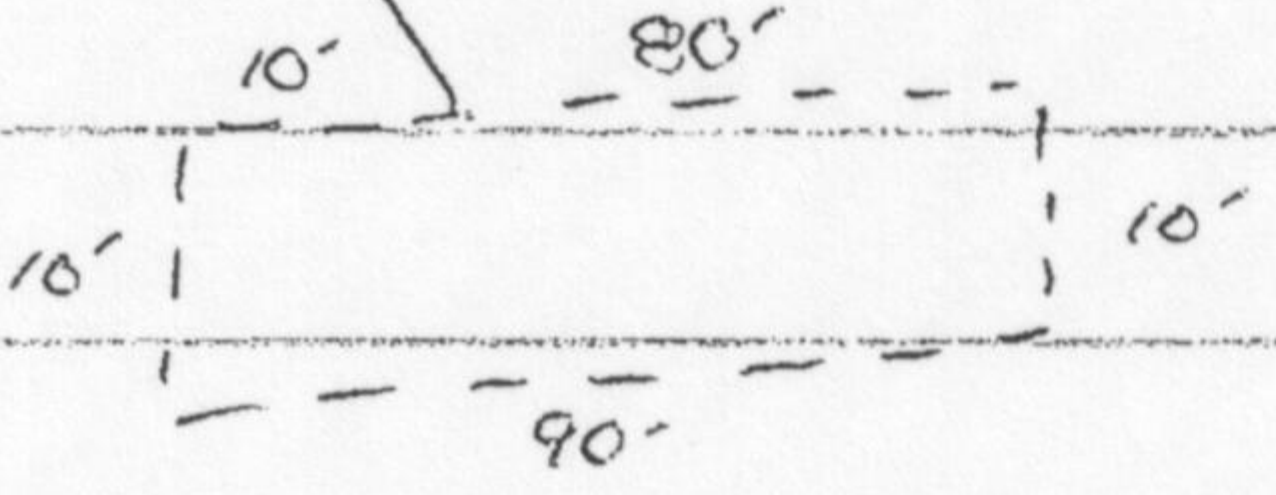

driveway

Co. Road