

**NORTHEAST TRI COUNTY HEALTH DISTRICT  
DIVISION OF ENVIRONMENTAL HEALTH**

**ON-SITE SEWAGE SYSTEM PERMIT # PT0006829**

Stevan & Earlene Mantle is hereby authorized to utilize a sewage disposal system at  
W2 SE4 SE4

Section: 35 Township: 38 Range: 38 Parcel #: 1997600

in accordance with the plans and specifications approved by the District Health Officer on file in this office.

Prior to any major repairs, replacements or alterations to the system a permit shall be obtained from the NorthEast Tri County Health District (Division of Environmental Health).

This permit is issued and may be revoked by the NorthEast Tri County Health District Health Officer by authority of WAC 246-272, and Northeast Tri County Health District Regulations established by the Board of Health pursuant to RCW 70.05.

Additional permits from other jurisdictions or agencies may be necessary for this project. It is the responsibility of the applicant to acquire said permit(s), and comply with all applicable rules, regulations and/or ordinances.

Date Issued: 08/30/2007



District Health Officer

**PERMIT INSTRUCTIONS**

**STRUCTURE TYPE:** Single-Family Residential

**NUMBER OF BEDROOMS:** 3

**DESIGN FLOW (gal/day):** 360

**TYPE OF SYSTEM:** New

**SYSTEM DESIGN:** Gravity w/ Gravelless Cha

**SEPTIC TANK CAPACITY (gal):** 1000

**DFLF/BED DIMENSIONS:** 258

**TRENCH DEPTH (inches):** 28

**TENCH WIDTH (inches):** 36

**APPURTANENCES:** Distribution Box

**PUMP CHAMBER (y/n):** N

**PUMP CHAMBER GALLONS:**

**REASON SYSTEM DESIGN:** Adequate soils

**SPECIAL PERMIT INSTRUCTIONS:** Optional effluent filter. Private shop connection. 15% reduction from 300' for use of gravelless chambers.

**FINAL INSPECTION DATE:**

9.12.07

**Initials:**

EM

**\*\* SEE REVERSE FOR AS BUILT DRAWING**

Stevens County Office

Pend Oreille County Office

Ferry County Office

P.O.Box 270

P.O. Box 490

P.O. Box 584

Colville,

Newport,

Republic,

WA

WA

WA

99114

99156

99166


(509) 684-2262

(509) 447-3131

(509) 775-3111

**NORTHEAST TRI COUNTY HEALTH DISTRICT**  
**AS-BUILT DRAWING - PERMIT # PT 6829**

INSPECTION DATE 9.12.07 INSPECTED BY Clj APPROVED:  YES  NO

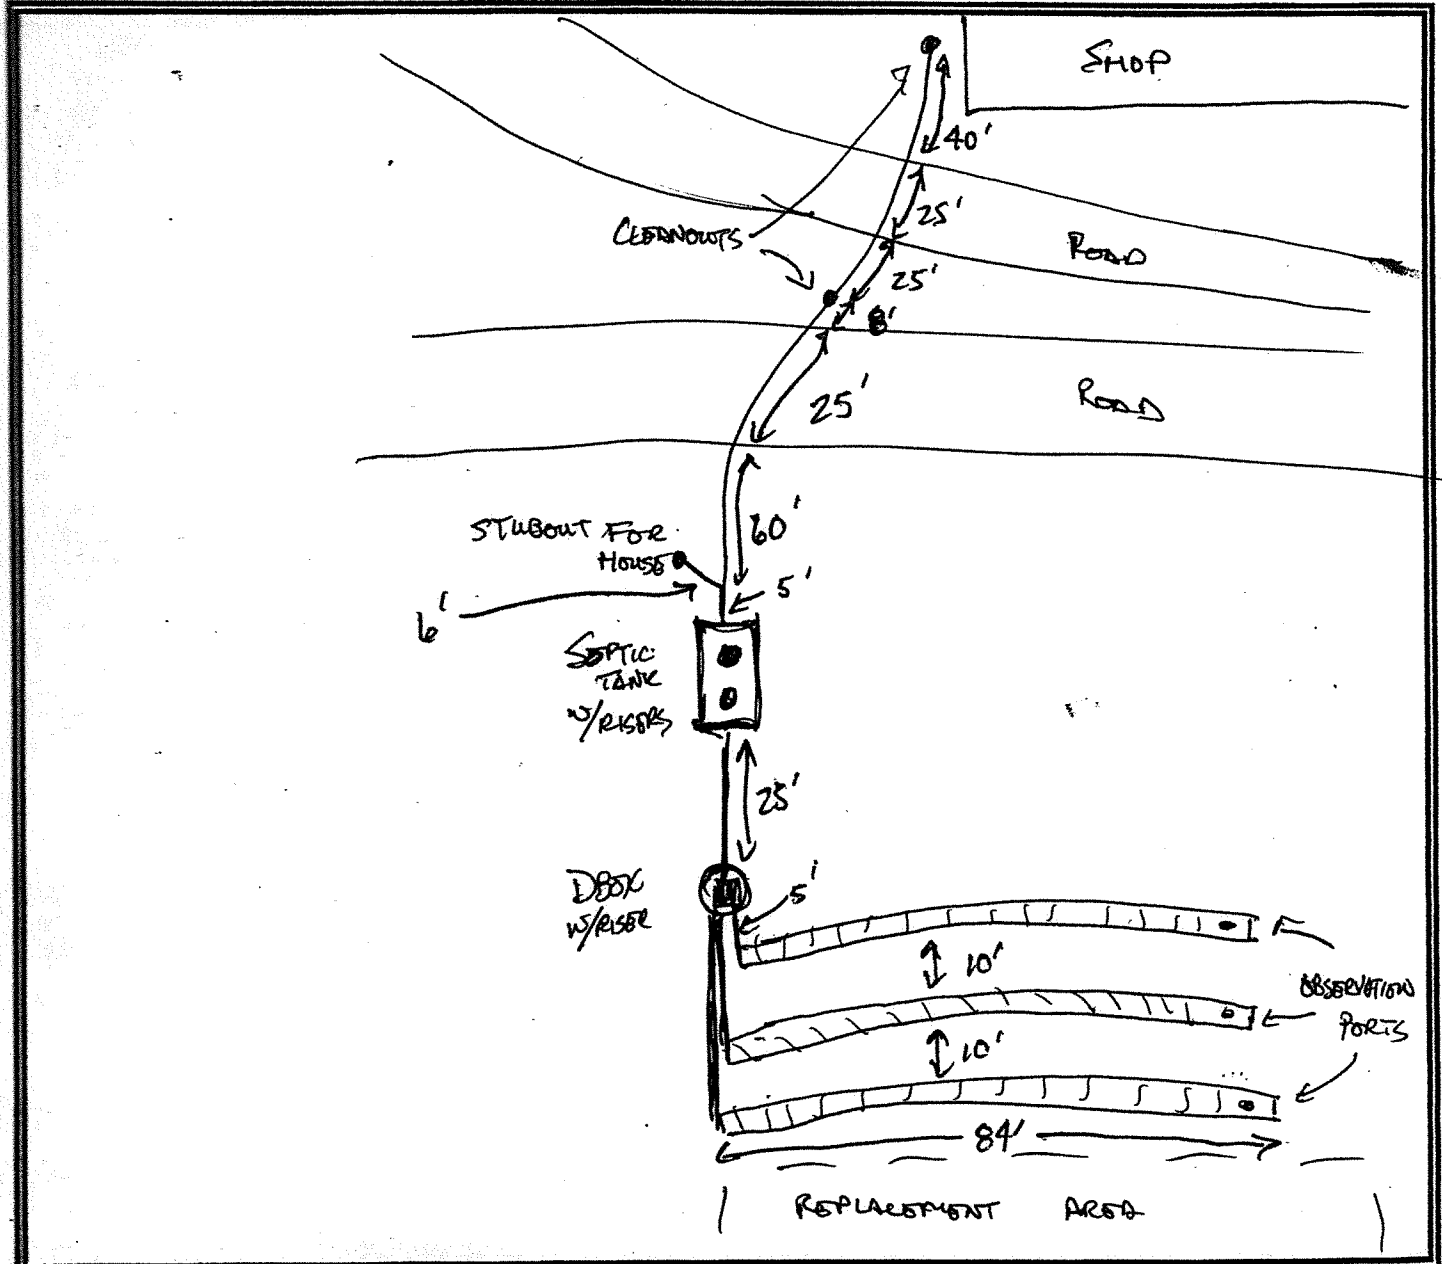

Installer Name Jim Maury  
 Septic Tank Size 1000 gal  
 Drainfield Length 258'  
 Drainfield Depth 28"

~~Pump Chamber Size \_\_\_\_\_  
 Doses/Day \_\_\_\_\_ Gallons/Dose \_\_\_\_\_  
 Squirt Height \_\_\_\_\_ Drawdown \_\_\_\_\_  
 Pump Run Time \_\_\_\_\_~~

(Revised 7/2003)