
OSS Search Request #4417

From Angela Schoenthal <aschoenthal@netchd.org>

Date Wed 4/16/2025 3:43 PM

To Debbie Baker <debbiekf@windermere.com>

 2 attachments (202 KB)

ON3391.pdf; Sewage Permit Record Search Request- Submission #4417.pdf;

Good Afternoon,

Please find attached the results of your sewage search request.

Permit #: C6201

of Bedrooms Permitted: 3

Thank you,

Angela Schoenthal

Lead Administrative Assistant

Northeast Tri County Health District

aschoenthal@netchd.org

Office: 509-775-3111

Direct: 509-563-8043

www.netchd.org



CONFIDENTIALITY NOTICE: This email, including any attachments, may contain confidential information which is intended only for the use of the recipient(s) named. If you receive this email message in error, please immediately notify the sender by email and delete it.

Dissemination, forwarding, printing, or copying of this email without prior consent of the sender is strictly prohibited.

This email may be considered subject to the Public Records Act and as such may be disclosed to a third-party requestor.

SR 3874

Septic Tank	1000	Gals.
Disp. Field	220	L.F.T
Other		
(X) New		
() Repair		

NORTHEAST TRI-COUNTY HEALTH DISTRICT
Division of Environmental Health

- (X) Colville Office, Box 270, Phone 684-2262
- () Newport Office, Box 490, Phone 447-3131
- () Republic Office, Box 584, Phone 775-3161

Permit No. C 6201

Fee Paid \$90.00

Receipt No. 438892

Gerald & Charlotte McKinney is hereby authorized to utilize a sewage disposal
Tax # 11 (Tract I, SP 5-84)
system at Sec. 2, Twp. 36, Rge. 33 and in accordance
with the plans and specifications approved by the District Health Officer on file in this office.

Any major repairs or alterations to the system shall be reported to the Northeast Tri-County Health District (Division of Environmental Health) for approval PRIOR to construction.

This permit is issued and may be revoked by the Northeast Tri-County Health District Health Officer by the authority of WAC 248-96, and Rules and Regulations established by the Board pursuant to RCW 70.05.

Witness my hand and seal this 9th day of August, 19 90


Date of Inspection 8/13/90 MM Anderson W. K. May, MD

C6201
02-36-36

road of P. J. Vessburg

SR 3874

no fence MC crady

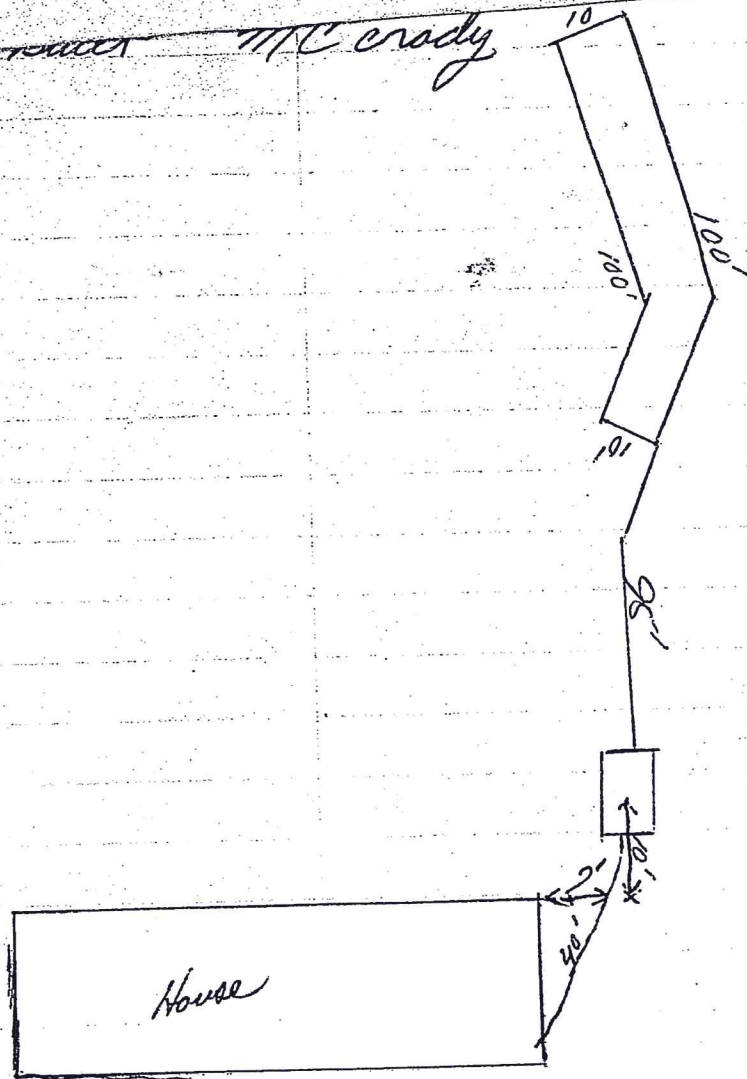

"As Built" provided by Rod Vincent
8/13/90