

SP0313 ✓✓
#3800962-
MINTERS
Lot 16-18
B1K3

**NORTHEAST TRI COUNTY HEALTH DISTRICT
DIVISION OF ENVIRONMENTAL HEALTH
ON-SITE SEWAGE SYSTEM PERMIT # 5000962**

Robert Everett is hereby authorized to utilize a sewage disposal system at


SUBDIVISION MINTERS LOT 16-18 BLOCK 3
Section: 32 Township: 37 Range: 38 Parcel #: 475000

in accordance with the plans and specifications approved by the District Health Officer on file in this office.

Prior to any major repairs, replacements or alterations to the system a permit shall be obtained from the Northeast Tri County Health District (Division of Environmental Health).

This permit is issued and may be revoked by the Northeast Tri County Health District Health Officer by authority of WAC 246-272, and Northeast Tri County Health District Regulations established by the Board of Health pursuant to RCW 70.05.

Additional permits from other jurisdictions or agencies may be necessary for this project. It is the responsibility of the applicant to acquire said permit (s), and comply with all applicable rules, regulations and/or ordinances.

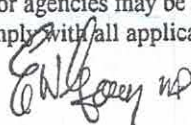

District Health Officer

Date Issued: 10/26/2000

PERMIT INSTRUCTIONS

STRUCTURE TYPE: **Single Family Residence**
NUMBER OF BEDROOMS: **3**
DESIGN FLOW (gal/day): **360**
TYPE OF SYSTEM: **New**
SYSTEM DESIGN: **Conventional Gravity**
SEPTIC TANK CAPACITY (gal): **1000**
REASON SYSTEM DESIGN: **Loamy fine sand**

DFLF/BED DIMENSIONS: **200'**
TRENCH DEPTH (inches): **18**
TRENCH WIDTH (inches): **36**
APPURTANENCES:
PUMP CHAMBER (y/n): **N**
PUMP CHAMBER GALLONS: **0**

SPECIAL PERMIT INSTRUCTIONS: **18" maximum drainfield trench depth**

FINAL INSPECTION DATE: 12 / 22 / 00


INITIALS: MM

**** SEE REVERSE FOR AS BUILT DRAWING**

SPC343

FINAL AS-BUILT DRAWING - PERMIT # 5000962

DATE OF FINAL INSPECTION 12/22/00 BY MM
ALLEY

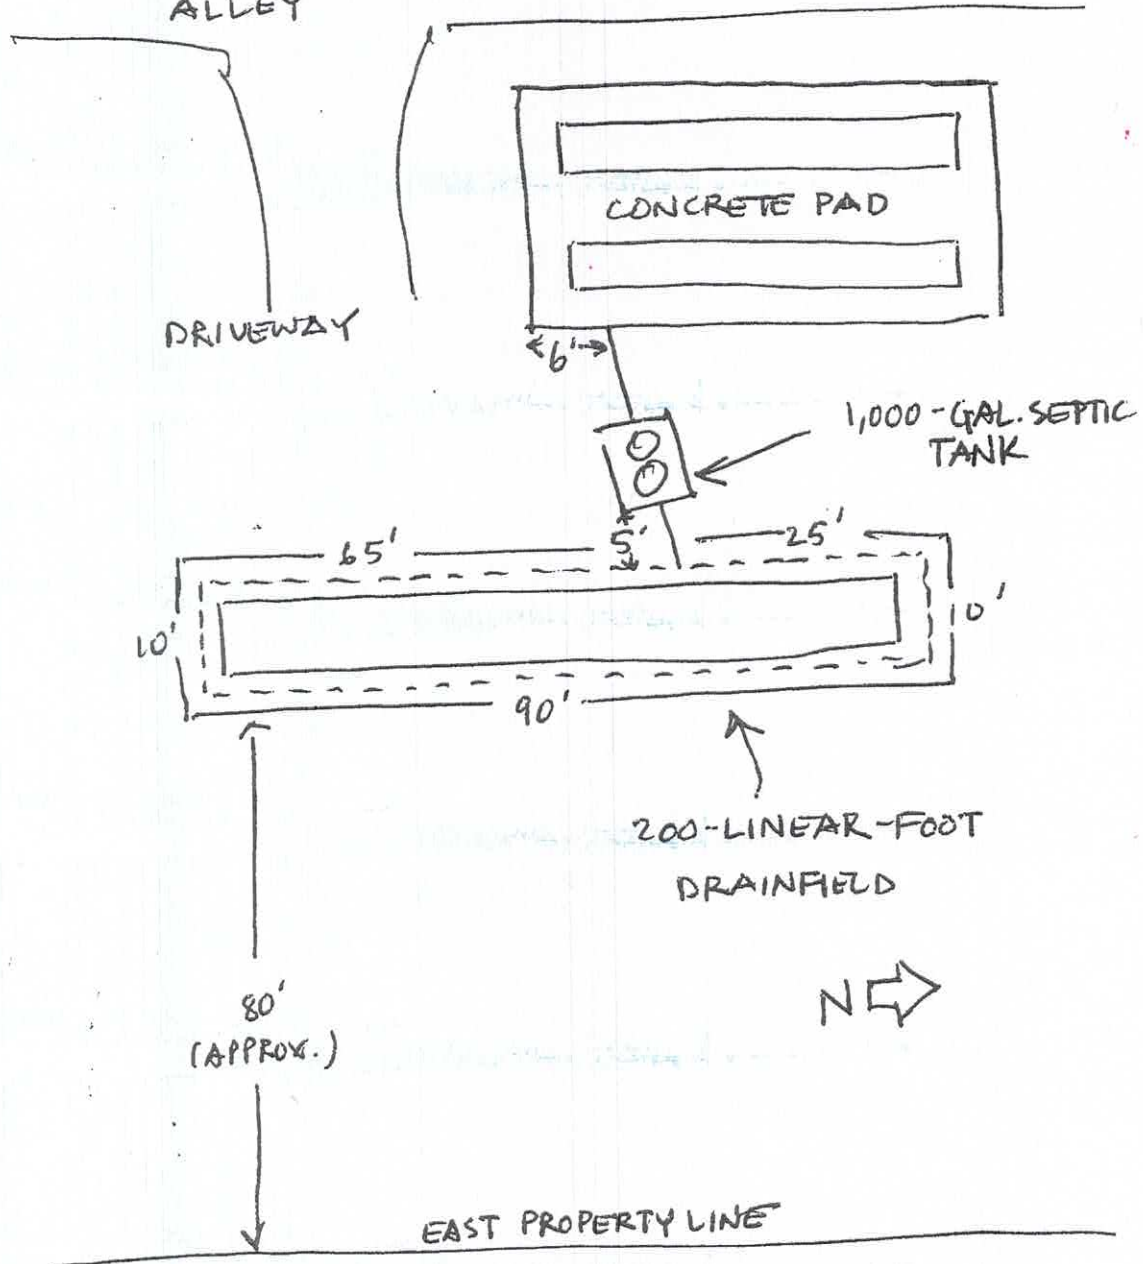

DESIGNED & INSTALLED BY VANCE DURPOS.

(REVISED 2/98)