

**NORTHEAST TRI COUNTY HEALTH DISTRICT
DIVISION OF ENVIRONMENTAL HEALTH**

ON-SITE SEWAGE SYSTEM PERMIT # PT0018666

Kathryn Patton is hereby authorized to utilize a sewage disposal system at
N RD 823 NE4 SE4

Section: 20 Township: 33 Range: 41 Parcel #: 5603000

in accordance with the plans and specifications approved by the District Health Officer on file in this office.

Prior to any major repairs, replacements or alterations to the system a permit shall be obtained from the NorthEast Tri County Health District (Division of Environmental Health).

This permit is issued and may be revoked by the NorthEast Tri County Health District Health Officer by authority of WAC 246-272, and Northeast Tri County Health District Regulations established by the Board of Health pursuant to RCW 70.05.

Additional permits from other jurisdictions or agencies may be necessary for this project. It is the responsibility of the applicant to acquire said permit(s), and comply with all applicable rules, regulations and/or ordinances.



Date Issued: 09/20/2018

District Health Officer

PERMIT INSTRUCTIONS

STRUCTURE TYPE: Single-Family Residential

NUMBER OF BEDROOMS: 2

DESIGN FLOW (gal/day):240

TYPE OF SYSTEM: New

SYSTEM DESIGN: Pressure Distribution

SEPTIC TANK CAPACITY(gal): 1000

DFLF/BED DIMENSIONS: 10 X 24

TRENCH DEPTH (inches): 48

TENCH WIDTH (inches):

APPURTANENCES: Effluent Filter

PUMP CHAMBER (y/n): Y

PUMP CHAMBER GALLONS: 500

REASON SYSTEM DESIGN: Type 1 Soils

SPECIAL PERMIT INSTRUCTIONS: Pressure Distribution with Sand Lined Bed

FINAL INSPECTION DATE: 9/27/18

Initials: AL

Stevens County Office

Pend Oreille County Office

Ferry County Office

240 E Dominion

605 Hwy 20

P.O. Box 584

Colville,

Newport,

Republic,

WA

WA

WA

99114

99156

99166

(509) 684-2262


(509) 447-3131

(509) 775-3111



On-Site Sewage System As-Built Drawing for Permit # PT 18666

Inspection Date	9/27/18	Approved ☒ Yes ☐ No	Approved Date	9/27/18
Inspection By	Alice Campbell		Re-Inspection Date	—

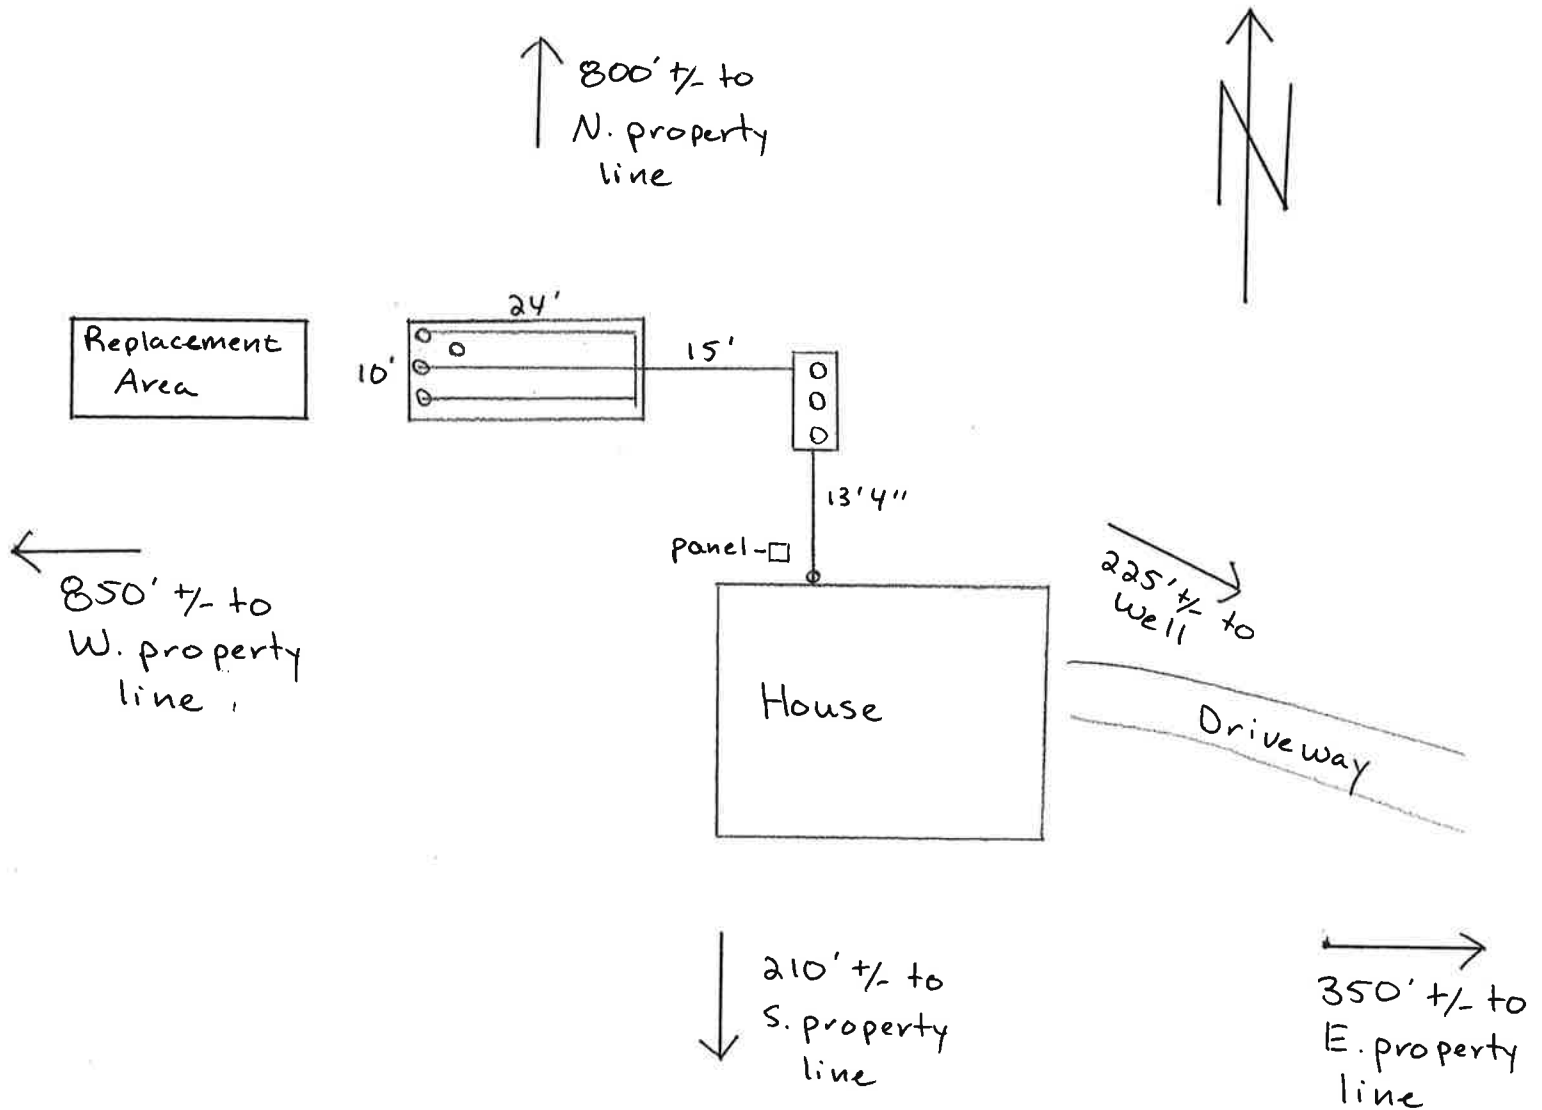

Installer Name	Steve Fitzgerald		Pump Chamber Size		500g
Septic Tank Size	1000g	Dose/day	6	Gallons/Dose	40
Drainfield Length	10' x 24'	Squirt Height	33"	Drawdown	3.4"
Drainfield Depth	48"	Pump Run Time	1:65		
Septic Tank Latitude/Longitude	48.34242, -117.65216				