On-Site Sewage System As-Built Drawing for Permit # PT 20766

Inspection Date	9/28/22	Approved ☑ Yes ☐ No		Approved Date	9/28/22
Inspection By	BH			Re-Inspection Date	

* Replacement

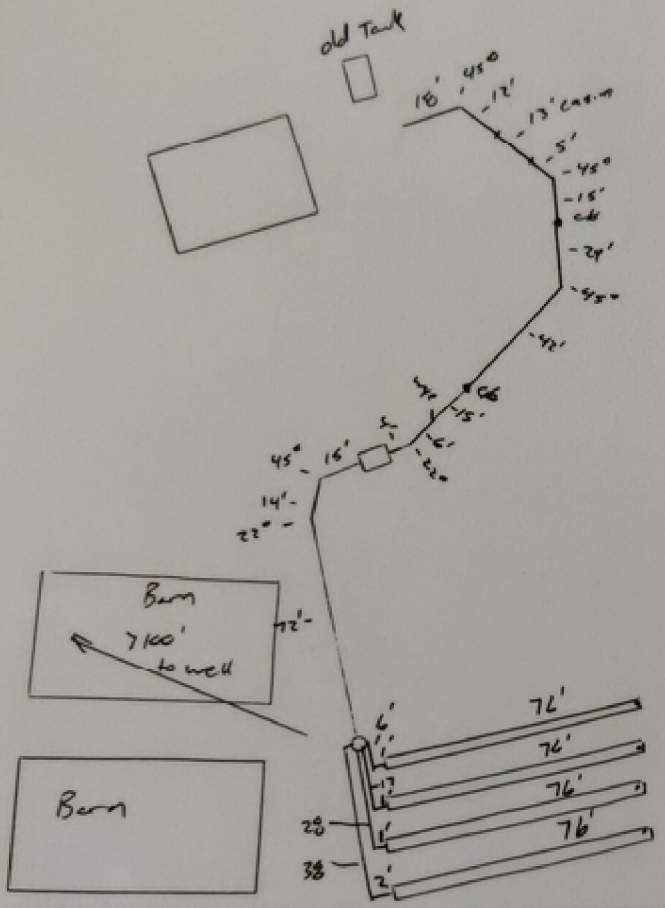

Installer Name	Greg Sloan			Pump Chamber Size	
Septic Tank Size	1500	Dose/day		Gallons/Dose	
Drainfield Length	304'	Squirt Height		Drawdown	
Drainfield Depth	18"	Pump Run Time			
Septic Tank Latitude/Longitude	48.4001 / -117.9279				